

1 EXISTING ROOF PLAN
8,718 SQFT

SF (415) 230-0452
LA (323) 284-7817
NY (347) 354-1758


DISCLAIMER
THIS DRAWING IS THE RESULT OF AN ARCHITECTURAL SURVEY AND IS NOT TO BE USED FOR CONSTRUCTION, LEASING, AND GENERAL PLANNING. IT SHOULD NOT BE USED FOR EXACT MEASUREMENTS OR AS THE BASIS FOR PURCHASES OF SPECIFIC ITEMS WITHOUT FIELD VERIFICATION.

LOS ANGELES, CA 90077

ROOF PLAN

DRAWN BY: TH FIELD SURVEY
AUDITED BY: TF 04/06/2020 - 04/21/2020
CAT# 10614 LA SHEET SIZE: 24x36

A-100

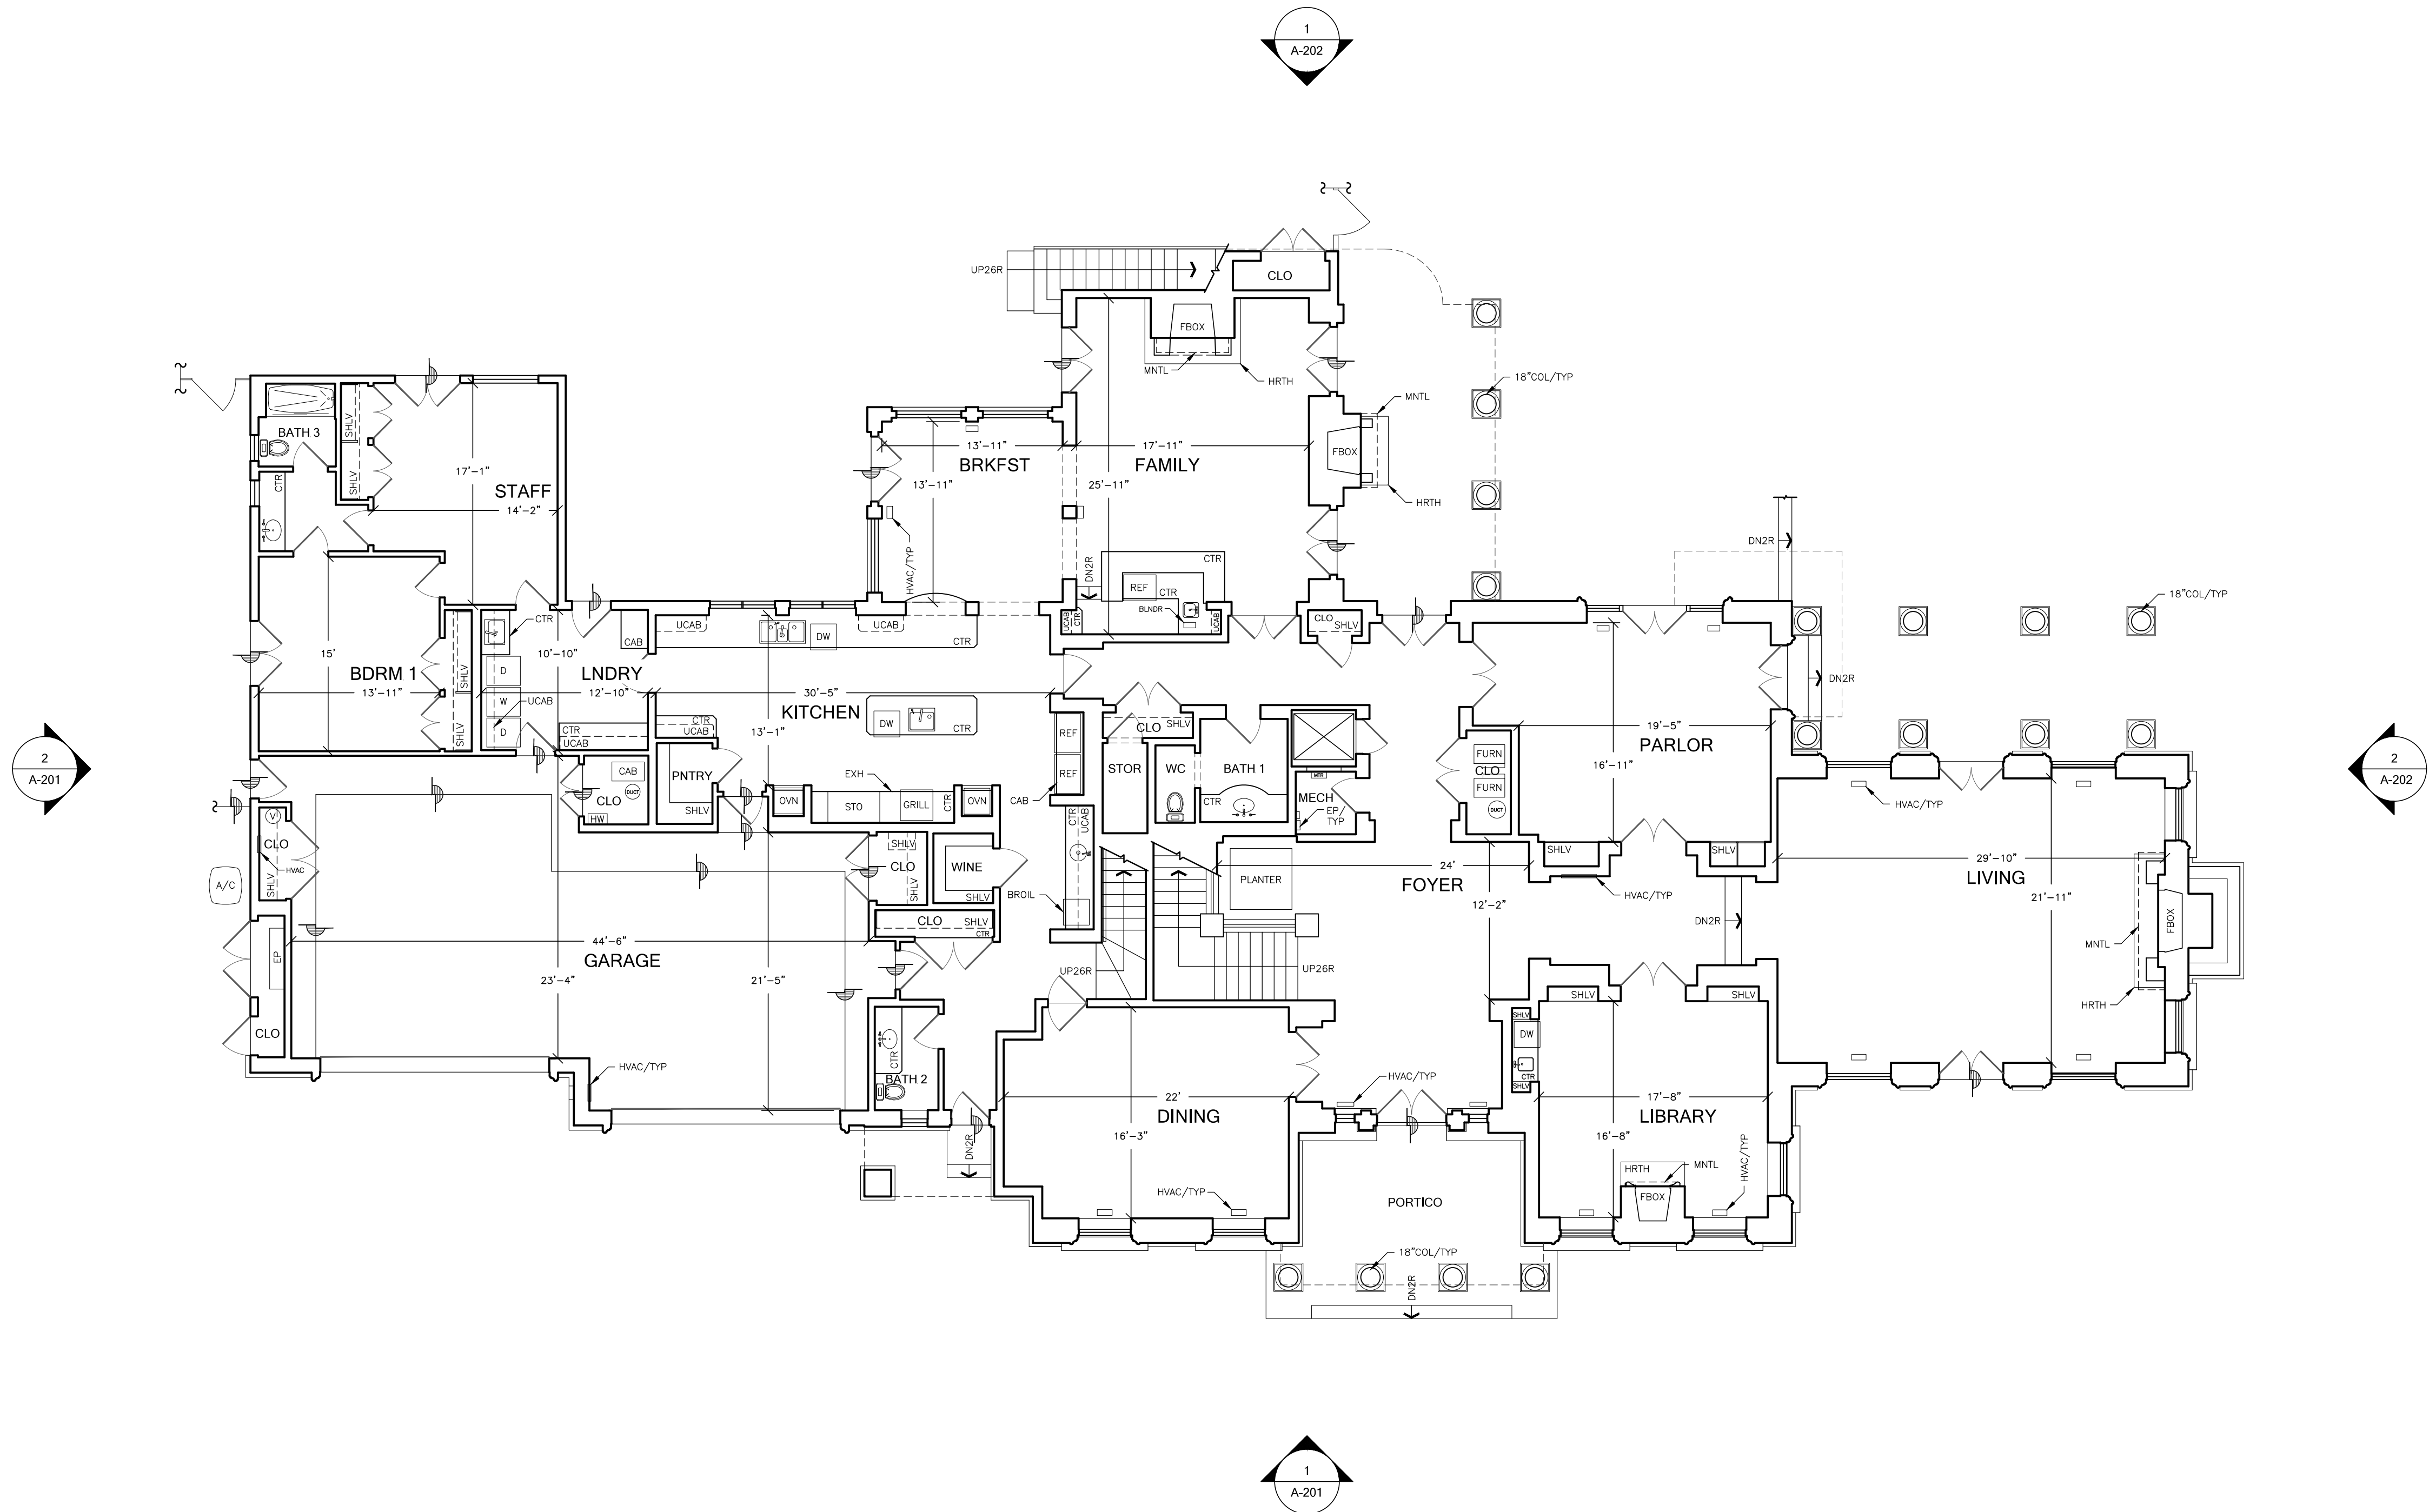

1 EXISTING ENTRY LEVEL FLOOR PLAN
 7,154 SQFT INTERIOR
 290 SQFT EXTERIOR

SF (415) 230-0452
 LA (323) 284-7817
 NY (347) 354-1758


DISCLAIMER
 THIS DRAWING IS THE RESULT OF AN ARCHITECTURAL SURVEY
 AND IS NOT TO BE USED FOR CONSTRUCTION, LEASING,
 OR GENERAL PLANNING. IT SHOULD NOT BE USED
 FOR EXACT MEASUREMENTS OR AS THE BASIS FOR PURCHASES
 OF SPECIFIC ITEMS WITHOUT FIELD VERIFICATION.

LOS ANGELES, CA 90077

FLOOR PLAN

DRAWN BY: TH FIELD SURVEY
 AUDITED BY: TF 04/06/2020 - 04/21/2020
 CAT# 10614 LA SHEET SIZE: 24x36

A-101

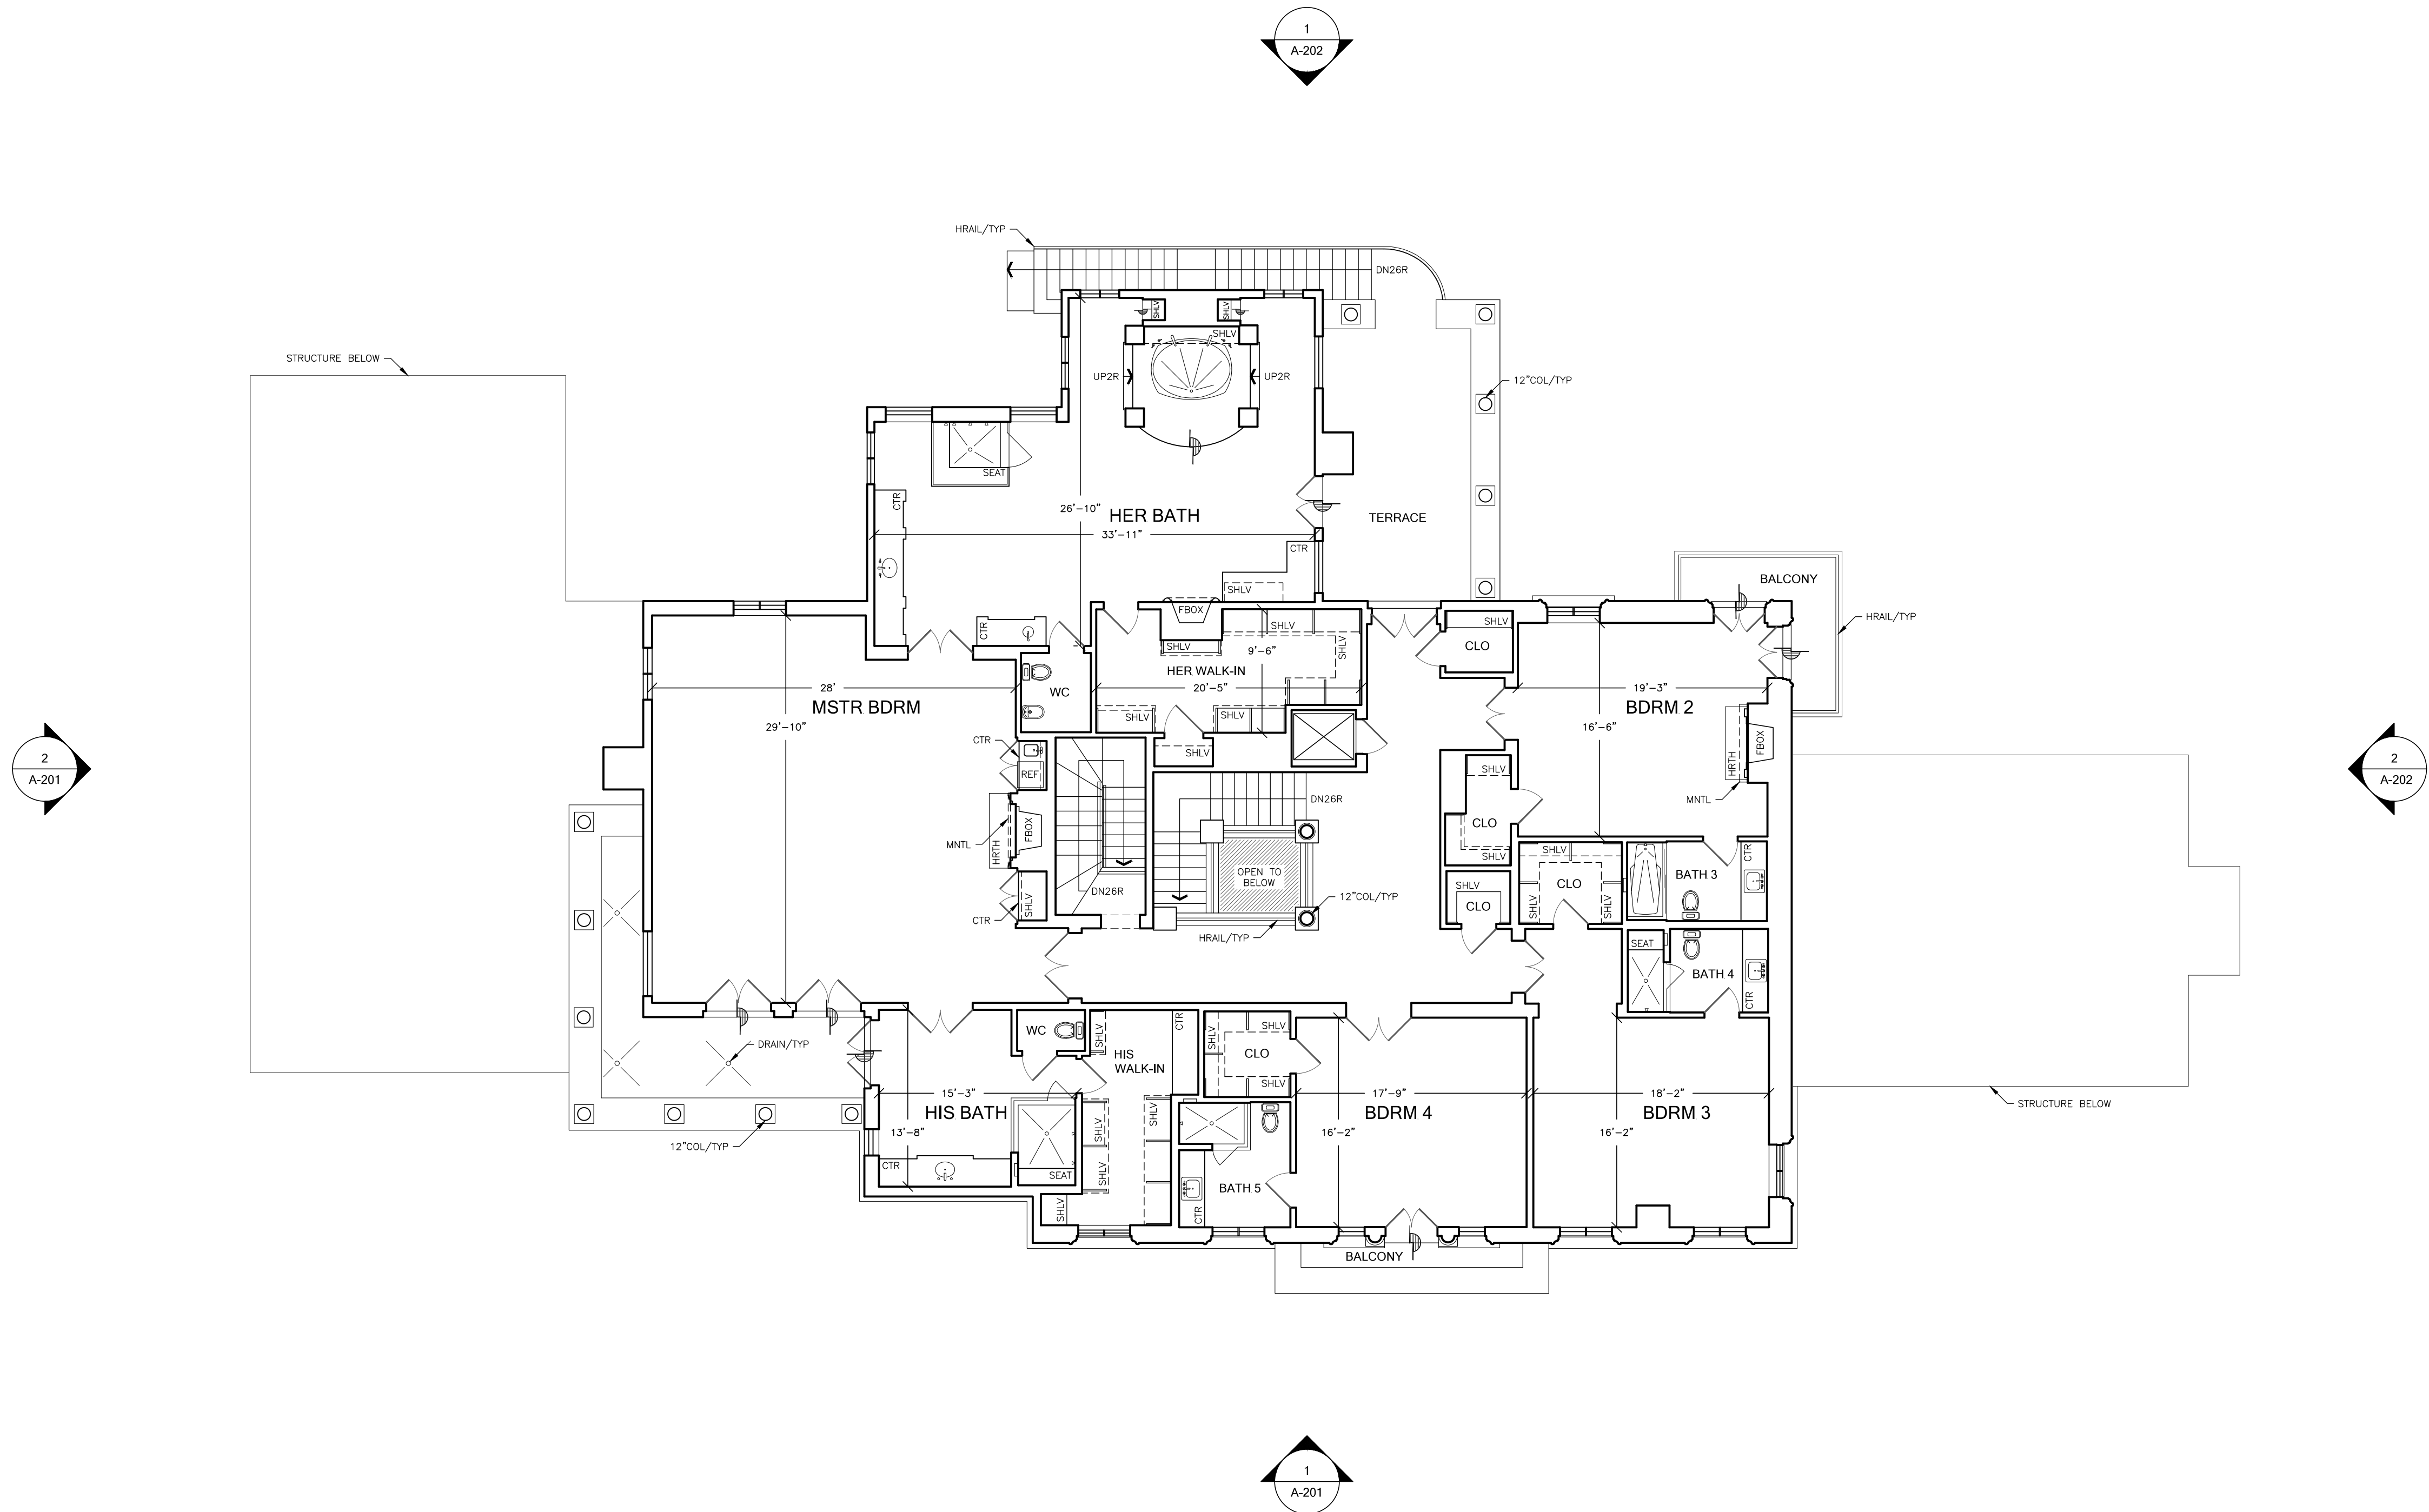

1 EXISTING SECOND LEVEL FLOOR PLAN
 4,721 SQFT INTERIOR
 877 SQFT EXTERIOR

SF (415) 230-0452
 LA (323) 284-7817
 NY (347) 354-1758


DISCLAIMER
 THIS DRAWING IS THE RESULT OF AN ARCHITECTURAL SURVEY
 AND IS NOT TO BE USED FOR CONSTRUCTION, LEASING,
 OR GENERAL PLANNING. IT SHOULD NOT BE USED
 FOR EXACT MEASUREMENTS OR AS THE BASIS FOR PURCHASES
 OF SPECIFIC ITEMS WITHOUT FIELD VERIFICATION.

LOS ANGELES, CA 90077

FLOOR PLAN

DRAWN BY: TH FIELD SURVEY
 AUDITED BY: TF 04/06/2020 - 04/21/2020
 CAT# 10614 LA SHEET SIZE: 24x36

A-101

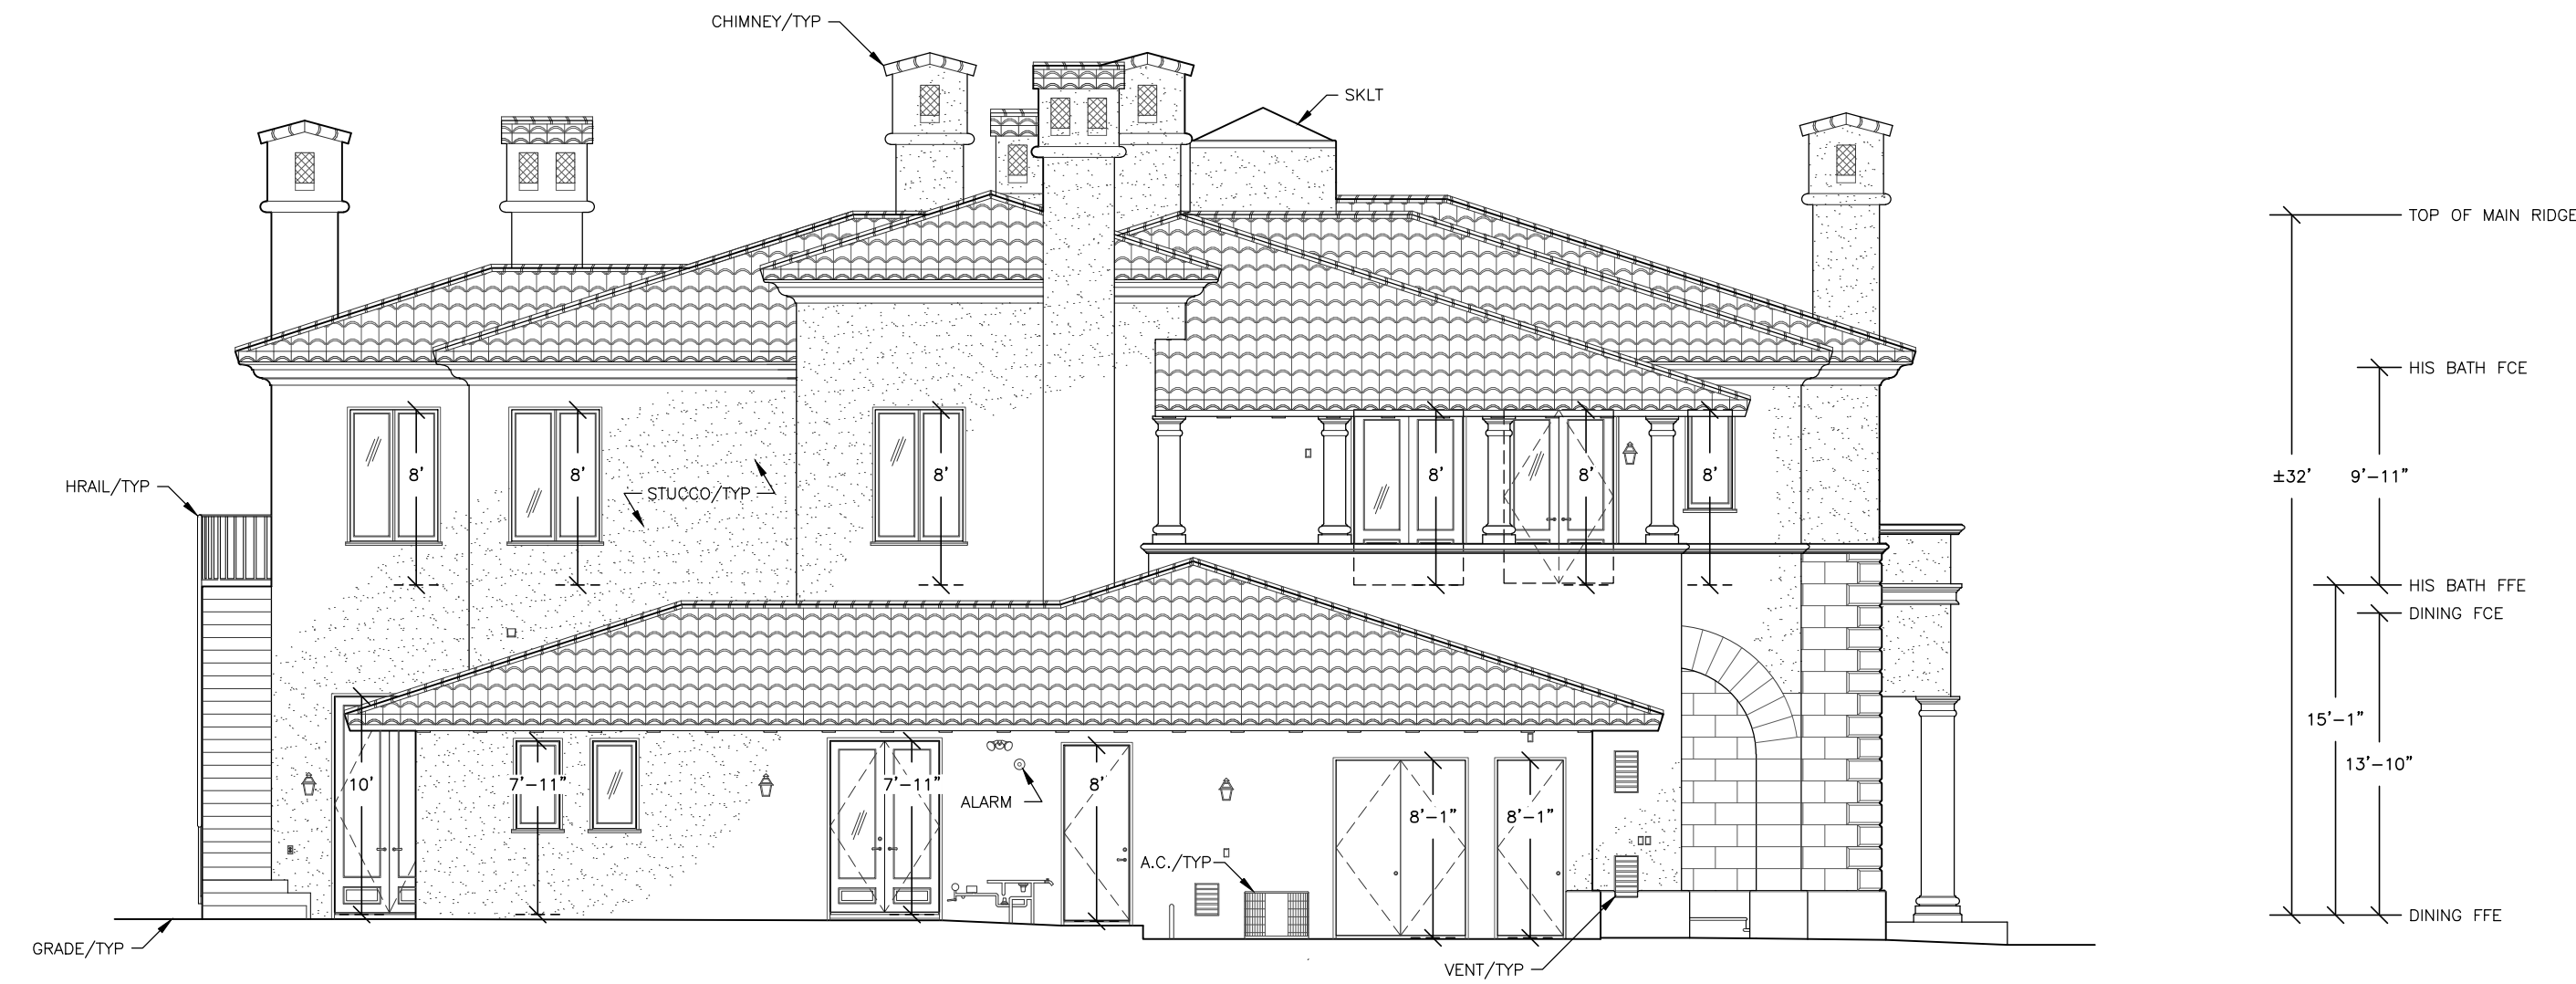

2 EXISTING SOUTHEAST ELEVATION



1 EXISTING NORTHEAST ELEVATION

SF (415) 230-0452

LA (323) 284-7817

NY (347) 354-1758

DISCLAIMER
THIS DRAWING IS THE RESULT OF AN ARCHITECTURAL SURVEY
CONDUCTED FOR GENERAL PLANNING PURPOSES ONLY.
FOR EXACT MEASUREMENTS OR AS THE BASIS FOR PURCHASES
OF SPECIFIC ITEMS WITHOUT FIELD VERIFICATION.

LOS ANGELES, CA 90077

ELEVATIONS

DRAWN BY: TH FIELD SURVEY

AUDITED BY: TF 04/06/2020 - 04/21/2020

CAT# 10614 LA SHEET SIZE: 24x36

A-201

SCALE: 1/8"=10" 4 OF 5



2 EXISTING NORTHWEST ELEVATION



1 EXISTING SOUTHWEST ELEVATION

SF (415) 230-0452

LA (323) 284-7817

NY (347) 354-1758

DISCLAIMER
THIS DRAWING IS THE RESULT OF AN ARCHITECTURAL SURVEY
CONDUCTED FOR THE PURPOSES OF AS-BUILT RECORDING.
IT IS NOT TO BE USED FOR CONSTRUCTION,
LEASING, AND GENERAL PLANNING. IT SHOULD NOT BE USED
FOR EXACT MEASUREMENTS OR AS THE BASIS FOR PURCHASES
OF SPECIFIC ITEMS WITHOUT FIELD VERIFICATION.

LOS ANGELES, CA 90077

ELEVATIONS

DRAWN BY: TH FIELD SURVEY
AUDITED BY: TF 04/06/2020 - 04/21/2020
CAT# 10614 LA SHEET SIZE: 24x36

A-202

SCALE: 1/8"=10" 5 OF 5